Friday, 06/07/2007 9:49:01 AM

User:

Linda Lacelle

### **Process Sheet**

Customer

Job Number

: CU-DAR001 Dart Helicopters Services : 33239

**Estimate Number** 

: 11877

P.O. Number This Issue

Prsht Rev.

First Issue

: NA

: 06/07/2007

: NC

: 27/06/2007

S.O. No. : NIA

Type

**Previous Run** Written By

Checked & Approved By

Comment

: MACHINED PARTS

Material

**Due Date** 

**Drawing Name** 

**Part Number** 

**Drawing Number** 

: D2208

: END CAP

: D2208 REV B

: N/A **Project Number Drawing Revision** 

: NA : 04/07/2007

Qty:

20 Um: Each

**Additional Product** 

Job Number:



Seq. #:

**Machine Or Operation:** 

Description:

6061-T6 .063 Sheet

M6061T6S063 1.0



Comment: Qty.:

0.1531 sf(s)/Unit

Total: 6061-T6 .063 Sheet

5052-H32 or 6061-T6 - .063" Thick

Batch M 193

3.0618 sf(s)

2.0 SHEAR

3.0

Comment: |

AAS CNC VERTICAL MACHINING #1

as per folie FA 032

4.0



B 07-07-04



Comment: INSPECT PARTS AS THEY COME OFF MACHINE

5.0

QC8

SECOND CHECK



Comment: SECOND CHECK



Dáte:

Friday, 06/07/2007 9:49:01 AM

User:

Linda Lacelle

**Process Sheet** 

Customer: CU-DAR001 Dart Helicopters Services

Drawing Name: END CAP

Job Number: 33239

Part Number: D2208

Job Number:



Seq. #:

**Machine Or Operation:** 

**Description:** 

6.0

PACKAGING 1

PACKAGING RESOURCE #1



Comment: PACKAGING RESOURCE #1

Identify and Stock

Location:



7.0

QC21






Comment: FINAL INSPECTION/W/O RELEASE

Job Completion



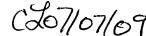

Form: rorocess

Wednesday, 6/27/2007 3:25:59 PM

Kim Johnston

Page 1

#### **Process Sheet**

: END CAP **Drawing Name** : CU-DAR001 Dart Helicopters Services Customer Job Number : 33239 **Estimate Number** : 11877 Part Number P.O. Number : D2208 REV &C PREUM S.O. No. : **Drawing Number** This Issue : 6/27/2007 : NC Prsht Rev. Project Number First Issue : // Type : MACHINED PARTS **Drawing Revision** Material Previous Run : 7/4/2007 Each **Due Date** Um: Written By Checked & Approved By : Est A 01.03.08 Comment New Issue POSITIVE RECALL **Additional Product** Job Number: Machine Or Operation: Description: Seq. #: 1.0 6061-T6 .063 Sheet Changed. prog-1 fai ready to RUN. Comment: Qty.: 0.1531 sf(s)/Unit Total: 6061-T6 .063 Sheet 5052-H32 or 6061-T6 - .063" Thick Batch M 100 285 2.0 SHEAR Comment: SHEAR Shear blanks: 5.100" x 4.100" 3.0 HAAS1 Comment: HAAS CNC VERTICAL MACHINING #1 Machine as per folio FA 032 Deburr 4.0 QC2 67-06-18 Comment: INSPECT PARTS AS THEY COME OFF MACHINE 5.0 QC8 SECOND CHECK Comment: SECOND CHECK PACKAGING 1 PACKAGING RESOURCE #1 6.0 Comment: PACKAGING RESOURCE #1 Identify and Stock Location:

# **Dart Aerospace Ltd**

W/O:		WORK ORDER CHANGES							
DATE STEP		PROCEDURE CHANGE			Date	Qty	Approval Chief Eng / Prod Mgr	Approval QC Inspector	

Part No:	PAR #:	Fault Category:	NCR: Yes No DQA:	Date:
			QA: N/C Closed:	Date:

NCR:		W	WORK ORDER NON-CONFORMANCE (NCR)							
DATE	STEP	Description of NC		Corrective Action Section B	Verification Approval	Approval				
DATE	SIEF	Section A	Initial Chief Eng	Action Description  Chief Eng	Sign & Date,	Section C	Chief Eng	QC Inspector		
क्रीक्षीउँ	\$ 20 water set	one part DUTAP. WHER Set cut inside the part leaving a small grove in the part RX. past more	Posion			Er	Posiour	er offorfor		

NOTE: Date & initial all entries

Date: User: . Wednesday, 6/27/2007 3:25:59 PM

Kim Johnston

**Process Sheet** 

· Customer: CU-DAR001 Dart Helicopters Services

Drawing Name: END CAP

Job Number: 33239

Part Number: D2208

Job Number:



Seq. #:

Machine Or Operation:

Description:

7.0

QC21

FINAL INSPECTION/W/O RELEASE



Comment: FINAL INSPECTION/W/O RELEASE

Job Completion



**POSITIVE RECALL** 

**EFFECTIVE** RELEASED

# **Dart Aerospace Ltd**

W/O:		WORK ORDER CHANGES	WORK ORDER CHANGES								
DATE	STEP	PROCEDURE CHANGE	Ву	Date	Qty	Approval Chief Eng / Prod Mgr	Approval QC Inspector				
Part No	o:	PAR #: Fault Category: NCR	R: Yes	No DQA	\:	Date:					

QA: N/C Closed: \_\_\_\_ Date: \_\_\_\_

NCR:		WORK ORDER NON-CONFORMANCE (NCR)							
		Description of NC		Corrective Action Section B		Verification	Approval	Annroyal	
DATE	STEP	Section A	Initial Chief Eng	Action Description Chief Eng	Sign & Date	Section C	Approval Chief Eng	Approval QC Inspector	
					:				
					·				
			1						


NOTE: Date & initial all entries

Drawing   Dimension   Accept   Reject   Method of   Inspection   Comments	DART AEROS	PACE LTD				Work Or	der: 2	3239	
FIRST ARTICLE INSPECTION CHECKLIST	Description: En	d Cap				Part Num	ber:	D2208	
FIRST ARTICLE INSPECTION CHECKLIST	Inspection Dwa	: D2208 Rev	: & C _				F	Page 1 of 1	-
Drawing   Dimension   Accept   Reject   Method of   Inspection   Comments		FIRS	T ARTICLE IN		_			_	_
S-963 4 470 +/-0.010	Drawing Dimension		,	Accept	Reject			omments	
R0.10	965 4 <del>.020</del>		<del></del>			/	/		
Ro.13	<del>5.053</del> 4 97	+/-0.010	4975						
Measured by: M/Rev Date: Change   Revised by, Approved   Revised by,	R0.10 /	<del></del>	R,iO						
Measured by: M/Rev Date: Onlog Date: Onlog Revised by, Approved Revised		<del> </del>	R,13						_
Date: O7-06-78 Date: O7/06/29 Date: N/A  Rev Date Change Revised by Approved	0.063	+/-0.010	.063						_
Rev Date Change Revised by Approved				<u> </u>	1-0		<del></del>		$\dashv$
Revised by Approved  4 04 11 11 New Issue P/O D206-539-013				U 41061	27				
	Rey Date 4 04.11.11	Change New Issue	P/O D206-5	39-013			Revised by	Approved	-



DESIG	N RF	DRAWN BY	DART AEROSPACE LTD HAWKESBURY, ONTARIO, CANADA	
CHEC	KED	APPROVED	DRAWING NO.	REV. B
	#	1 4	D2208 SHEET	1 OF 1
DATE			TITLE	SCALE
01.0	2.22		END CAP	1:1
Α		94.09.01	NEW ISSUE	
В		01.02.22	REDRAWN	

RELEASED

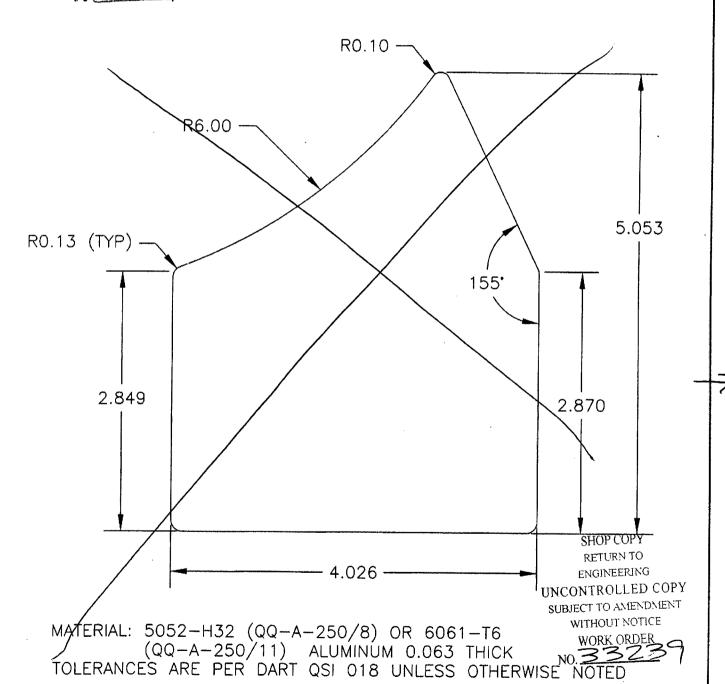


Copyright © 1994 by DART AEROSPACE LTD

THIS DOCUMENT IS PRIVATE AND CONFIDENTIAL AND IS SUPPLIED ON THE EXPRESS CONDITION THAT IT IS NOT TO BE USED FOR ANY PURPOSE OR COPIED OR COMMUNICATED TO ANY OTHER PERSON WITHOUT WRITTEN PERMISSION FROM DART AEROSPACE LTD.



DESIGN DRAWN BY DART AEROSPACE LTD HAWKESBURY, ONTARIO, CANADA CHECKED APPROVED DRAWING NO. REV. C D2208 SHEET 1 OF 1 DATE TITLE SCALE 07.06.28 **END CAP** 1:2 DATE DESCRIPTION

-2

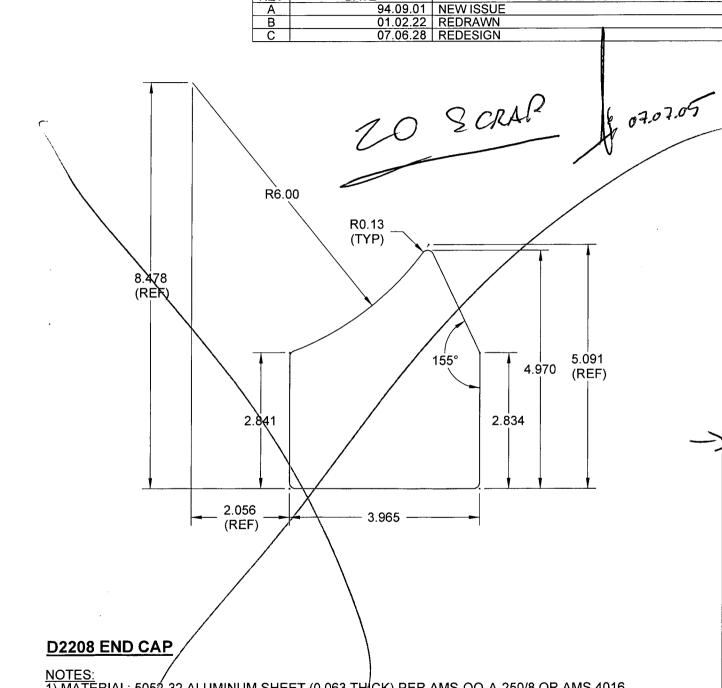

1) MATERIAL: 5052-32 ALUMINUM SHEET (0.063 TH/CK) PER AMS-QQ-A-250/8 OR AMS 4016 (RÉF. DART SPEC. M5052H32S.063) OR

6061-T6 (OR 6061-T62) ALUMINUM SHEET (0.063 THICK) PER AMS-QQ-A-250/11 OR AMS 4025 OR AMS 4027

(REF. DART SPEC. M6061T6S.063)

2) FINISH: NONE

3) TOLERANCES ARE PER DART QSI 018 UNLESS OTHERWISE NOTED

REV

4) ALL DIMENSIONS ARE IN INCHES UNLESS OTHERWISE NOTED


5) BREAK ALL SHARP EDGES 0.005 TO 0.010 MAX

#### COPYRIGHT © 1994 BY DART AEROSPACE LTD

## PRELIMINARY ISSUE

DESIGN DRAWN BY DART AEROSPACE LTD HAWKESBURY, ONTARIO, CANADA				
CHECKED APPROVED		DRAWING NO. D2208	REV. C SHEET 1 OF 1	
07.07.05		END CAP	SCALE 1:2	
DEV	DATE	DESC	DIDTION	

			-
REV	DATE	DESCRIPTION	Π
Α	94.09.01	NEW ISSUE	
В	01.02.22	REDRAWN	
C	07 07 05	REDESIGN	

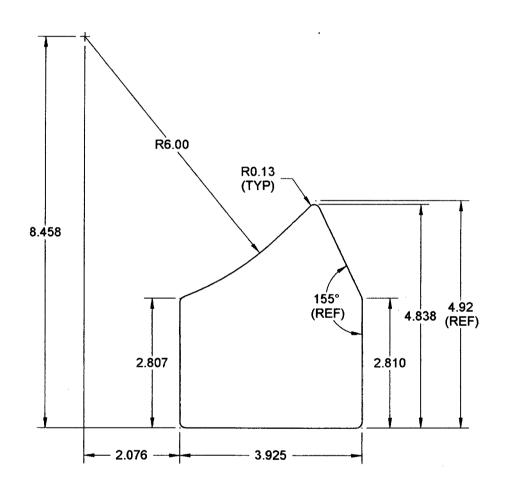

#### **D2208 END CAP**

NOTES:
1) MATERIAL: 5052-32 ALUMINUM SHEET (0.063 THICK) PER AMS-QQ-A-250/8 OR AMS 4016 (REF. DART SPEC. M5052H32S.063) OR 6061-T6 (OR 6061-T62) ALUMINUM SHEET (0.063 THICK) PER AMS-QQ-A-250/11

(REF. DART SPEC. M6061T6S.063)

2) FINISH: NONE

3) TOLERANCES ARE PER DART QSI 018 UNLESS OTHERWISE NOTED

4) ALL DIMENSIONS ARE IN INCHES UNLESS OTHERWISE NOTED 5) BREAK ALL SHARP EDGES 0.005 TO 0.010 MAX

#### **COPYRIGHT © 1994 BY DART AEROSPACE LTD**

'DAR' AEROSPAÇE LTD	33239	
		*-
Description: END LAD	Part Number:	D 2768
Inspection Dwg: D 3368 Rev: C		Page 1 of 1

### FIRST ARTICLE INSPECTION CHECKLIST

	х	First Artic	le	Proto	type	•
Drawing Dimension	Tolerance	Actual Dimension	Accept	Reject	Method of Inspection	Comments
3,925	± 6.010	3.9245	¥	·	UERN	-
4.838	± 2010	4.838	**		UERN	
R 1500	± 0.030	:155	*		R.6	
R.13	1 6010	ing.	+8		R.O	
<b>6</b> ,063	t 3010	,063	**		UERN	
	_					
		•				
1.						
					·	
Measured by:	D A	udited by:	<del></del>	Pr	ototype Approv	al·

. <u>.</u>					
Measured by:	æ	Audited by:	in	Prototype Approval:	
Date:	07-07-09	Date:	57/07/09	Date:	

Rev	Date	Change		- Andrews - Andr	Revised by	Approved
А	0441-11	New Issue	7/0	D 206539013	KJ/JLM	

			•	
	•			
				Add. Fig.
				1
<b>*</b>				

# **Dart Aerospace Ltd**

W/O:		WORK ORDER CHANGES								
DATE	STEP	PROCEDURE CHANGE	Ву	Date	Qty	Approval Chief Eng / Prod Mgr	Approval QC Inspector			
oHoHo	#20 160	1 A	S	othelos						
A	2310	Chang from HAAS to NATO jet and ADD dubur ste								
					<u> </u>					

Part No:	_ PAR #:	Fault Category:	NCR: Yes No	DQA:	Date:
			QA: N/C Closed:		Date:

NCR:			WORK ORD	ER NON-CONFORMANO	CE (NCR)			-					
DATE		Description of NC		Vorification	A								
	STEP	Section A	Initial Chief Eng	Action Description Chief Eng	Sign & Date	- Verification Section C	Approval Chief Eng	Approval QC Inspector					
				2.									
								· ·					

NOTE: Date & initial all entries